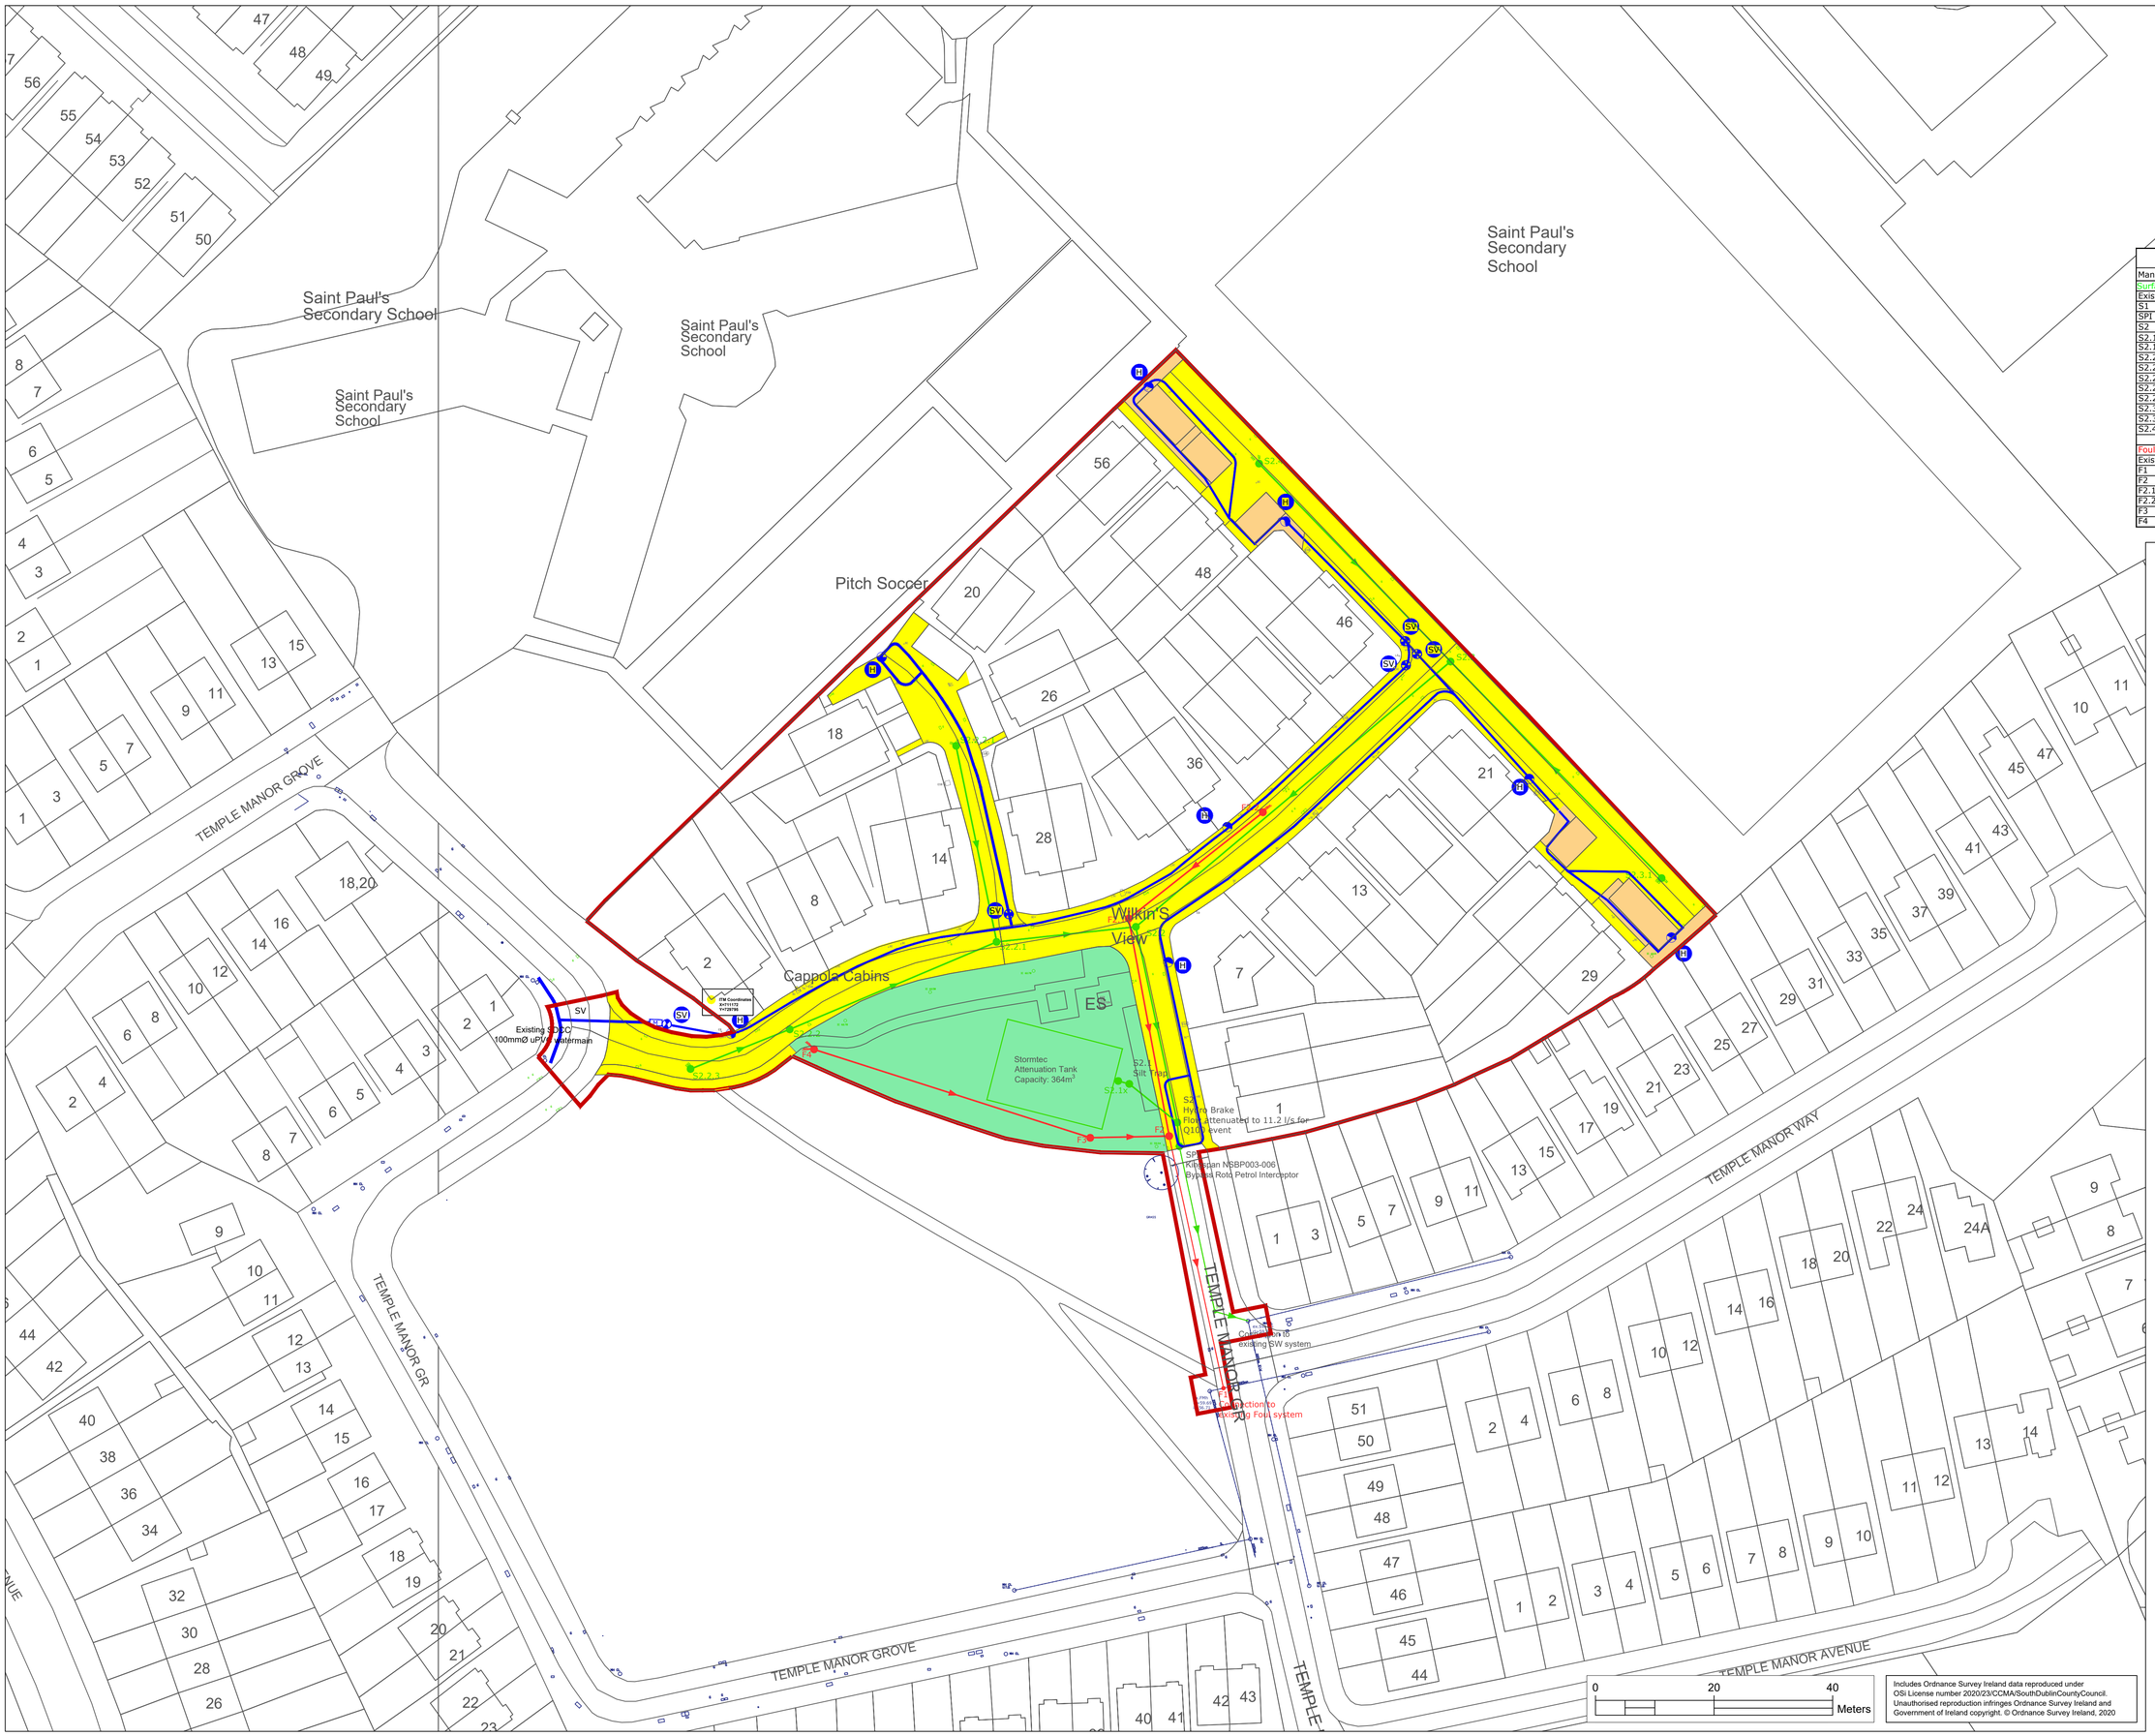

Wilkins View As-Constructed Levels

Manhole Ref	Cover Level	Invert Level	Pipe Size	Remarks
Surface Water				
Existing	59.79	57.20	225Ø	Existing Manhole
S1	59.85	57.33	225Ø	Connection to Existing
SPI	59.98	N/A	225Ø	Petrol Interceptor
S2	60.03	57.58	225Ø	Hydrobrake Manhole
S2.1	60.32	N/A	375Ø	Silt Trap
S2.1x	60.37	57.83	600Ø	Storage Tank Header
S2.2	60.54	57.82	375Ø	
S2.2.1	60.73	58.45	300Ø	
S2.2.2.1	61.09	58.90	225Ø	
S2.2.2	60.78	58.75	225Ø	
S2.2.3	60.77	59.25	225Ø	
S2.3	60.46	58.25	300Ø	
S2.3.1	59.89	58.66	225Ø	
S2.4	61.03	58.86	225Ø	
Foul				
Existing	59.69	56.71	225Ø	Existing Manhole
F1	59.64	56.73	225Ø	New Mh on Existing line
F2	59.98	57.90	225Ø	
F2.1	60.57	58.40	225Ø	
F2.2	60.27	58.77	225Ø	
F3	60.02	58.05	225Ø	
F4	60.88	58.68	225Ø	

ROADS AND FOOTPATHS PREVIOUSLY TAKEN IN CHARGE

PUBLIC OPEN SPACE PREVIOUSLY TAKEN IN CHARGE

NON OS MAPPING SHOWN IN MAGENTA

NOTE:-

THIS DRAWING DOES NOT CONSTITUTE A RECOMMENDATION TO HAVE AN ESTATE TAKEN IN CHARGE.

THIS DRAWING REFERS TO THE TAKEN INTO CHARGE OF THE ROADS AND SERVICES AS INDICATED IN COLOUR.

ALL SEWERS ARE 225mm Dia. UNLESS OTHERWISE STATED.

SCALE DIMENSIONS NOT TO BE USED.

LENGTH OF ROADS AS ON ATTACHED ROAD SCHEDULE.

BOUNDARY TREATMENTS TO ROADS TAKEN IN CHARGE i.e. WALLS AND / OR RAILINGS ARE NOT INCLUDED IN & ARE NOT PART OF THE TAKEN IN CHARGE PROCEDURE.

Legend:-

Foul Water	F1	RED
Storm Water	SW1	GREEN
Drinking Water		BLUE
HYDRANT	H	SLUICE VALVE SV
AIR VALVE	AV	WATER METER M
Foul Water under 225mm	F1	GREY
Storm Water under 225mm	SW1	GREY
Open Spaces to be TIC		
Roads & Footpaths TIC		
Areas to remain Private / MGMT. Co.		
Wayleave		
Site Boundary Line		RED

Rev	Description	Date

Comhairle Contae Átha Claith Theas

South Dublin County Council

Building & Development Control

Comhairle Contae Átha Cliath Theas
South Dublin County Council

M. Mulhern
Director of Land Use Planning & Transportation Dept

John Hegarty
Senior Engineer

Taking in Charge Scheme

Wilkins View
Walkinstown
Dublin 12

Area Committee :- Rathfarnham / Templeogue / Firhouse / Bohernabreena

Drawn: PL	Scale: 1:500 @ A1	Building Control No.
Chkd. PMcG	Date: June 2021	BC - 1454
O.S. Ref. 3327-19, 3327-20	Status: Taken in Charge	

Includes Ordnance Survey Ireland data reproduced under OSi License number 2020/23/CCMA/SouthDublinCountyCouncil. Unauthorised reproduction infringes Ordnance Survey Ireland and Government of Ireland copyright. © Ordnance Survey Ireland, 2020