


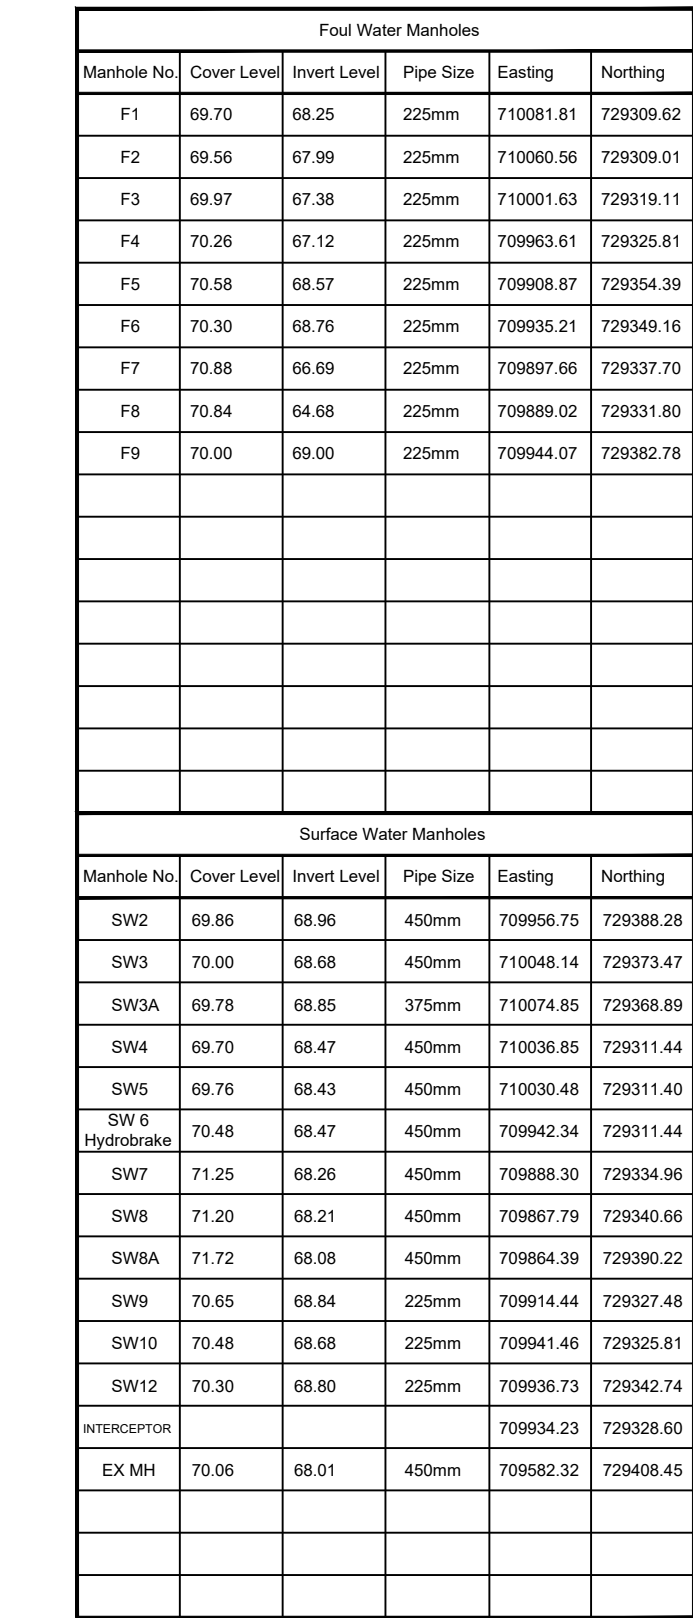

Legend:


Rev	Description	Date

SDCC Comhairle Contae
Átha Cliath The
South Dublin
County Council

Planning and Transport

Eoin Burke Director	John Hegarty Senior Engineer
------------------------	---------------------------------

NOTE:-
THIS DRAWING DOES NOT CONSTITUTE A RECOMMENDATION TO HAVE
ESTATE TAKEN IN CHARGE.
THIS DRAWING REFERS TO THE TAKEN INTO CHARGE OF THE ROADS &
SERVICES AS INDICATED IN COLOUR.
ALL SEWERS ARE 225mm Dia. UNLESS
OTHERWISE STATED.
SCALE DIMENSIONS NOT TO BE USED.
LENGTH OF ROADS AS ON ATTACHED ROAD SCHEDULE.
BOUNDARY TREATMENTS TO ROADS TAKEN IN CHARGE i.e. WALLS AND
RAILINGS ARE NOT INCLUDED IN & ARE NOT PART OF THE TAKEN IN
CHARGE PROCEDURE.

Drawing Title

Temple Woods
Greenhills Road
Dublin 24

Drawing Title

Taking in Charge Scheme

Drawn JK	Scale 1:500 @ A1	Drawing Number BC-1458
Chkd. PL	Date April 2025	
O.S. Ref. 3327-23	Status Taking in Charge	

Taking in Charge Note:

South Dublin County Council will maintain all roads, footpaths, public lighting and storm water systems including SUDS related infrastructure as well as all trees, Class 1 open space grass areas and playgrounds and furniture approved as part of the planning permission.

South Dublin County Council will not maintain services deemed to be the responsibility of Uisce Éireann and other utility providers. Allocated parking bays, ornamental planting schemes, smaller grassed areas and verges and additional features not approved at the planning stage unless otherwise agreed are the responsibility of the residents, residents association or designated management company.

Includes Tailte Éireann data reproduced under Licence number
CYALS0441442 South Dublin County Council.
Unauthorised reproduction infringes Tailte Éireann and
Government of Ireland copyright.
© Tailte Éireann - Surveying.